



PLATE I OF 17


[illegible]

AOE3-845-2285203
PUGET SOUND NAVAL SHIPYARD

| | | REVISIONS | | | |
|------|-----|--|------|------------|-------------|
| ZONE | REV | DESCRIPTION | BY | CONTR DATE | U.S.N. DATE |
| | | THIS PLAN HAS BEEN CHECKED AGAINST ACTUAL CONDITIONS BY PHYSICAL SURVEY AND HAS BEEN UPDATED TO INCLUDE ALL MODIFICATIONS AND SHIP ALLS DURING 1980, AT COASTAL DRY DOCK AND REPAIR CON., 1980. | E.G. | 3/27/81 | 1/25/81 |
| A | | PLATE 2 CHANGED TO REFLECT TASK LIGHT MOOS AND PLATE 5 CWS INSTL. DURING FY 85 PMA NORSHIPCO. | RJO | 8/08/85 | 1/25/81 |
| B | | CHANGED HEIGHTS FOR THE FOLLOWING: 1. ANCHOR LT-AFT FROM 60'-4" TO 78'-0" 2. STERN LT-BLUE FROM 65'-7" TO 65'-0" 3. STERN LT-WHT (P) FROM 65'-7" TO 65'-0" 4. WHT TASK LIT FROM 160'-3" TO 159'-6" 5. ADDED BRIDGE WING WINDOWS, PYS. 6. HIGHEST POINT ON SHIP FROM 185'-9" TO 183'-0" TO 183'-0" 7. HIGHEST FIXED POINT ON SHIP FROM 157'-11" TO 155'-2" | SUR | 12/06/80 | 1/25/81 |
| D | | ADDED COMPT 95-65-2 Q, FAN RM. | | 8/1/89 | 1/25/81 |
| E | | THIS SELECTED RECORD DRAWING UPDATED TO REFLECT CONDITIONS EXISTING ONBOARD THE SHIP AFTER FY 82 PMA. | GBN | 1/25/81 | 1/25/81 |
| F | | NO CHANGES TO THIS DRAWING FOR THE FY 82 PMA. | CAC | 1/25/81 | 1/25/81 |
| G | | THIS SELECTED RECORD DRAWING UPDATED TO REFLECT CONDITIONS EXISTING ONBOARD THE SHIP AFTER FY 84 PMA. | HL5 | 1/25/81 | 1/25/81 |
| H | | THIS SELECTED RECORD DRAWING UPDATED TO REFLECT CONDITIONS EXISTING ONBOARD THE SHIP AFTER FY 86 PMA. | HL5 | 1/25/81 | 1/25/81 |
| I | | THIS DRAWING REVISED TO REFLECT SHIP CONDITION AS OF FY 86 PMA. | HL5 | 1/25/81 | 1/25/81 |
| J | | THIS DRAWING REVISED TO REFLECT SHIP CONDITION AS OF FY 86 PMA. | HL5 | 1/25/81 | 1/25/81 |
| K | | DRAWING REVISED TO REFLECT SHIP CONDITION AS OF FY 86 PMA. | HL5 | 1/25/81 | 1/25/81 |

| HEIGHT ABOVE BOTTOM OF KEEL | |
|--|----------|
| HIGHEST POINT ON SHIP (TOP OF UNF ANT TYPE AS/OS-UNC ON FOREMAST FR 1) | 148'-0" |
| * MASTHEAD LIGHT | 173'-0" |
| * RANGE LIGHT | 181'-0" |
| * HORIZONTAL DISTANCE BETWEEN MASTHEAD AND RANGE LIGHTS | 339'-0" |
| * ANCHOR LIGHT - FWD | 70'-0" |
| * ANCHOR LIGHT - AFT | 70'-0" |
| SIDE LIGHT - PORT | 91'-7" |
| SIDE LIGHT - STBD | 91'-7" |
| STERN LIGHT - BLUE (S) | 65'-0" |
| STERN LIGHT - WHITE (P) | 65'-0" |
| WAKE LIGHT | 83'-0" |
| AIRCRAFT WARNING LIGHTS FR 69 % | 153'-6" |
| WHITE TASK LIGHTS | 143'-0" |
| BLINKER LIGHTS ON YARDARM % | 162'-7" |
| MAIN OVEBOARD & BREAKDOWN LIGHTS - UPPER - | 156'-1" |
| TOP OF AS/OS&A/FS-100 | 168'-0" |
| HIGHEST FIXED POINT ON SHIP (BOLTED CONNECTION ON MAINMAST FR 205) | 157'-11" |
| 04 LEVEL | 93'-3" |
| 05 LEVEL | 102'-3" |
| FOREMAST PLATFORM | 129'-3" |
| UPPER PLATFORM | 140'-0" |
| TOPMAST PLATFORM | 160'-6" |
| SECONDARY CONNING STATION | 93'-3" |
| * MEASURED DIMENSION | |


| SMALL BOATS | | | |
|-------------|------------------------------------|-----------|-------|
| NUMBER | NAME | PERSONNEL | TOTAL |
| 2 | 24'-0" RIGID INFLATABLE BOAT (RIB) | 18 | 36 |
| 1 | 33'-0" PERSONNEL BOAT | 24 | 24 |
| 1 | 50'-0" UTILITY BOAT | 146 | 146 |
| 30 | ENCAPSULATED LIFEBOAT | 25 | 750 |
| | | TOTAL | 956 |

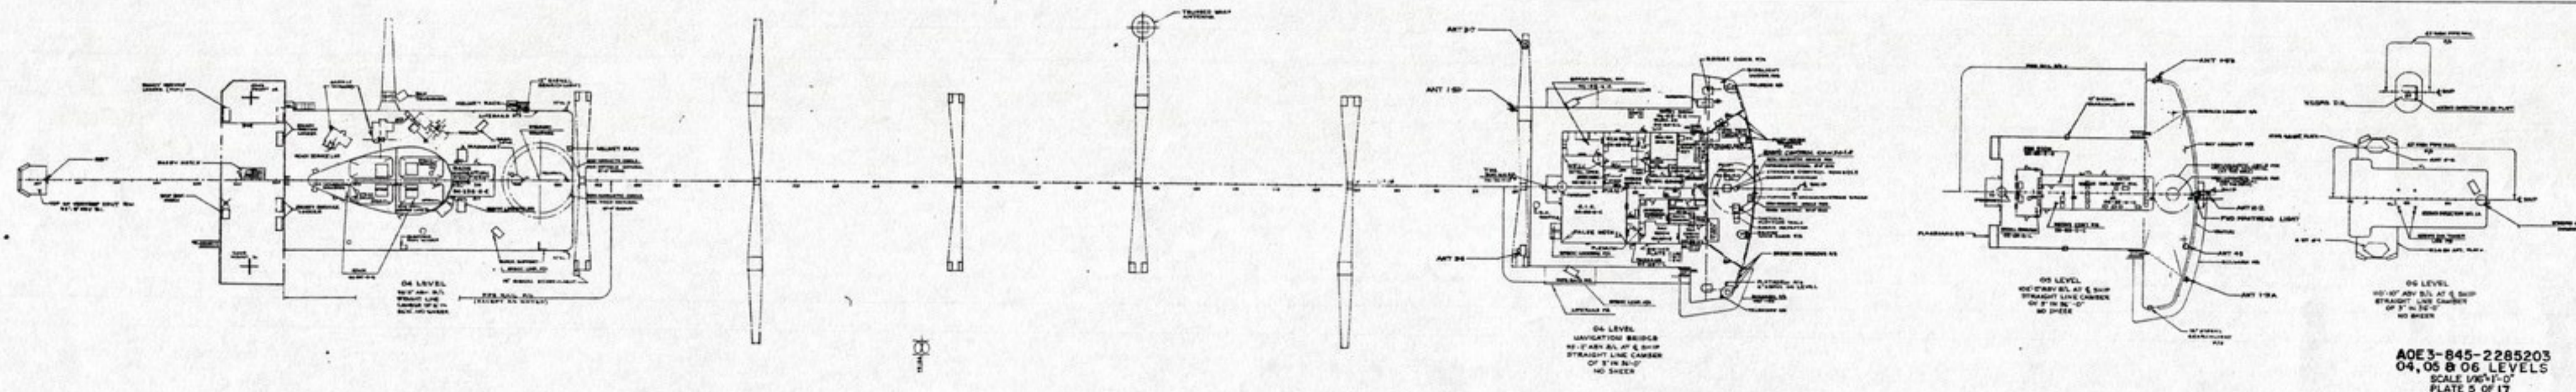

AOE3-845-2285203
GENERAL INFORMATION
PLATE 2 OF 17

AOE3-845-2285203
04, 05 & 06 LEVELS
SCALE 1/8"=1'-0"
PLATE 5 OF 17

| | | | | | |
|--|--|---|--|--|--|
| | | PUGET SOUND NAVAL SHIPYARD BREMERTON, WASHINGTON | | | |
| EXAMINED DATE 251 BY CHAPPEE TEL. NO. 3421 DRAWING NO. 84-36-36 CATEGORY CRVP DRAWN BY SHUPFREY | | U.S.S. SEATTLE (AOE 3) BOOKLET OF GENERAL DRAWINGS COVER SHEET GENERAL INFORMATION DATA 04, 05 & 06 LEVELS U.S.S. BOOKLET OF GENERAL DRAWINGS | | | |
| SELECTED RECORD DRAWING | | APPROVED <i>[Signature]</i> DATE 12 SEP 1974 PRICE 80064 845 2265203 ORDER NO. 1-600-110-2 | | | |


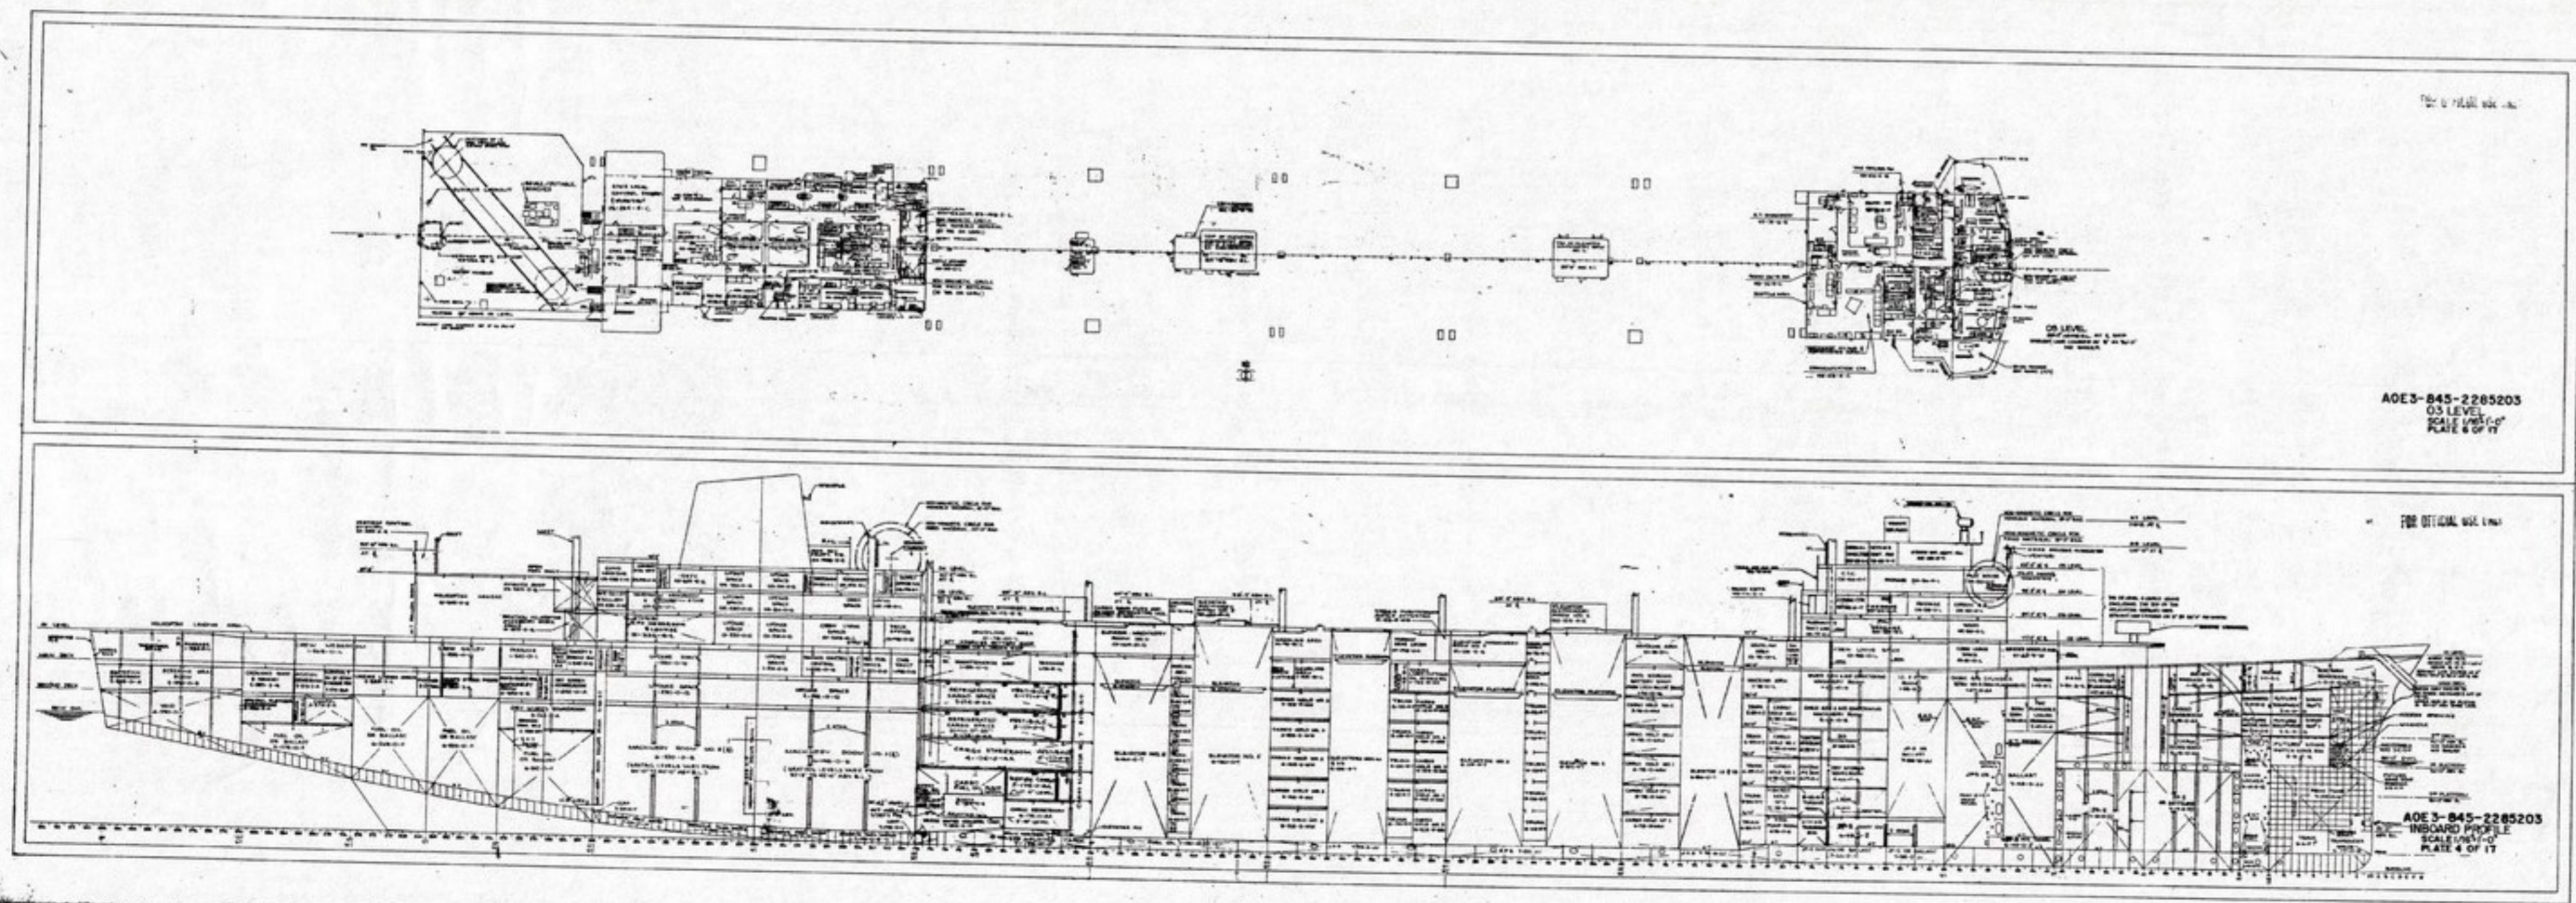


| REVISIONS | | | | |
|-----------|------|---|-----------|--------|
| NO. | REV. | DESCRIPTION | BY | DATE |
| 1 | | THIS PLAN HAS BEEN CHECKED AGAINST ACTUAL CONDITIONS BY PHYSICAL SURVEY AND HAS BEEN UPDATED TO INCLUDE AGE MODIFICATIONS AND SHIP-ALTS DURING R.O.H. AT COASTAL DRY DOCK AND REPAIR CORP., 1980. | E.S. 2078 | 5.1.80 |
| 2 | | COMPARTMENT CHANGES MADE IN PLATES 4 AND 5 DURING FY 85 PMA MODIFICATIONS. | U.S. 2078 | 5.1.80 |
| 3 | | REMOVED INWALL IN OUTWALL WINCHES AT YR 250 PL. 6 OF 16. REPLACED WITH NEW INWALL OUTWALL WINCH AT YR 250 PL. 6 OF 16, DURING FY 86 PMA MODIFICATIONS. | U.S. 2078 | 5.1.80 |

AVAILABILITY NO. 108 2-942-558203
SHEET 3 OF 8.1

REFLECTED SECOND DRAWING
LITE BOOKLET OF GENERAL DRAWINGS INBOARD PROFILE OF TANK

| | |
|---|---------------------|
| PUGET SOUND NAVAL SHIPYARD BREMERTON, WASHINGTON | |
| USS SEATTLE (AOE 3) | |
| BOOKLET OF GENERAL DRAWINGS INBOARD PROFILE 03 LEVEL | |
| EXAMINED | APPROVED |
| SELECTED RECORD DRAWING | BOOK 64 845 2285203 |


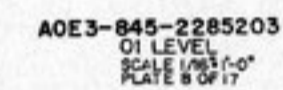
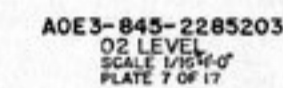


| | | | |
|----------------------------|---|-----|-----------------|
| PUGET SOUND NAVAL SHIPYARD | | | |
| BREMERTON, WASHINGTON | | | |
| EXAMINED | USS SEATTLE (AOE 3) | | |
| NAME | BOOKLET OF GENERAL DRAWINGS | | |
| DATE | MAIN DECK O1 LEVEL O2 LEVEL | | |
| TIME | THIS BOOKLET OF GENERAL DRAWINGS | | |
| BY | | | |
| REMARKS | | | |
| APPROVED | APPROVED _____ | | DATE _____ |
| DATE | ISSUE _____ | | ISSUED BY _____ |
| | REVISION _____ | | |
| SELECTED RECORD DRAWING | 80064 | 945 | 2285203 |
| | SCALE 1/8"=1'-0" | | HEET 2 OF 7 |

| TITLE | BOOKET OR GENERAL DRAWINGS | WIN DECK | 01 TEND | 05 TEND |
|-------------------------|----------------------------|----------|---------|---------|
| SELECTED RECORD DRAWING | | | | |

100

2

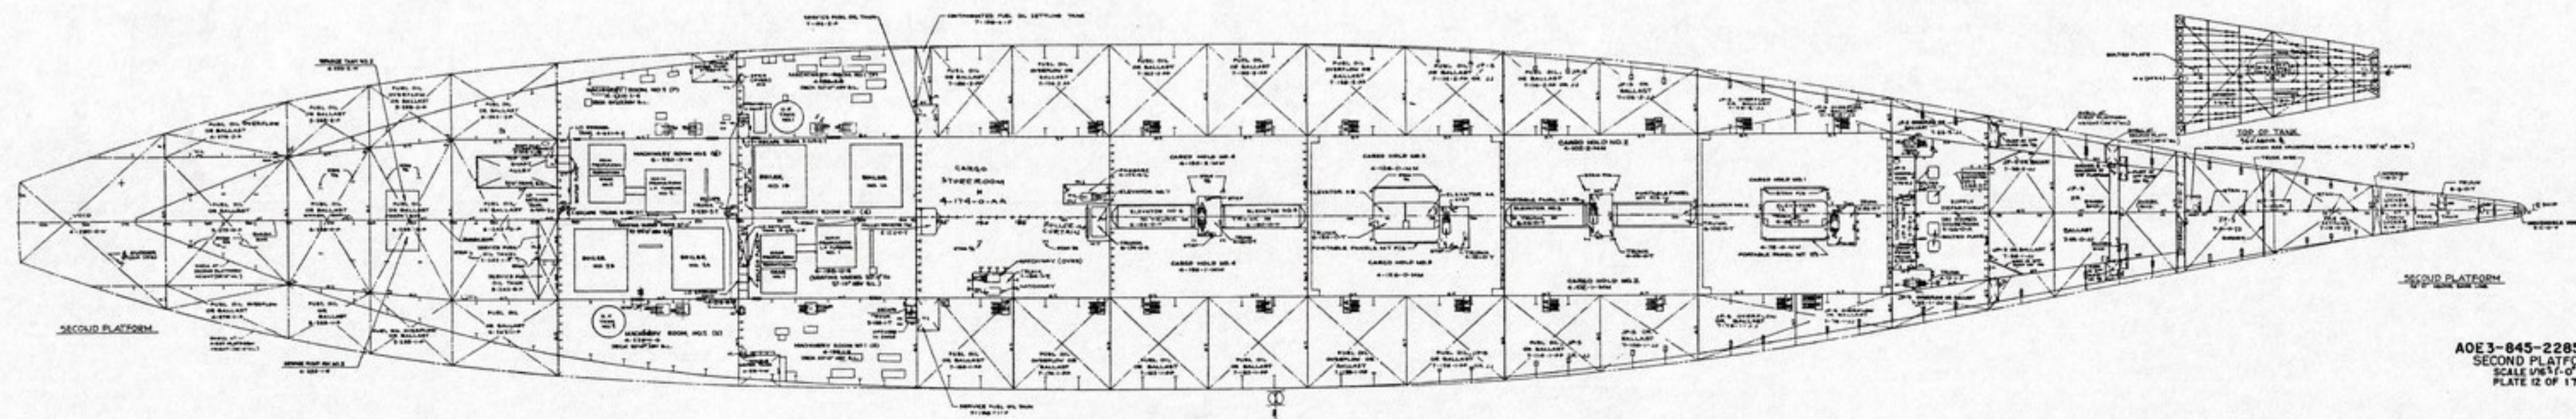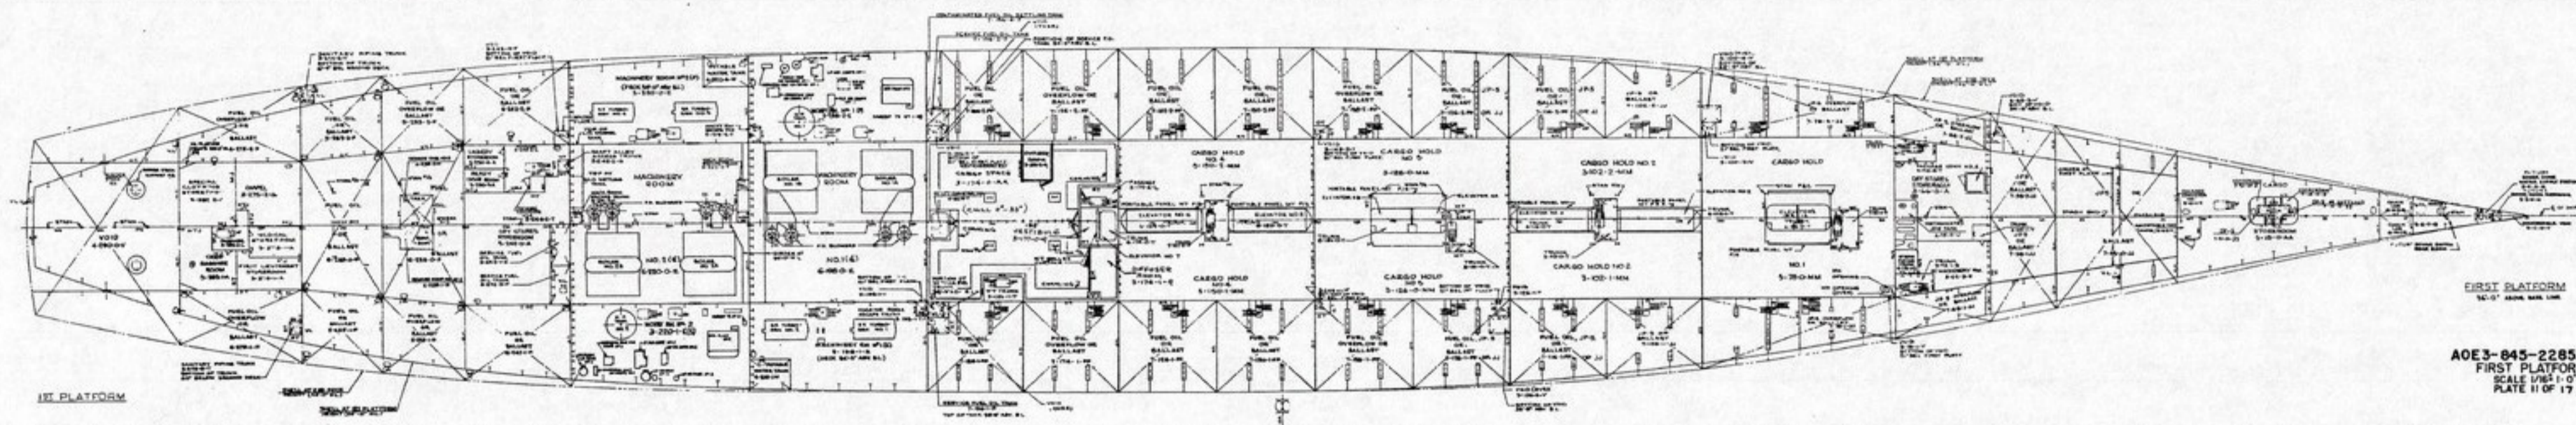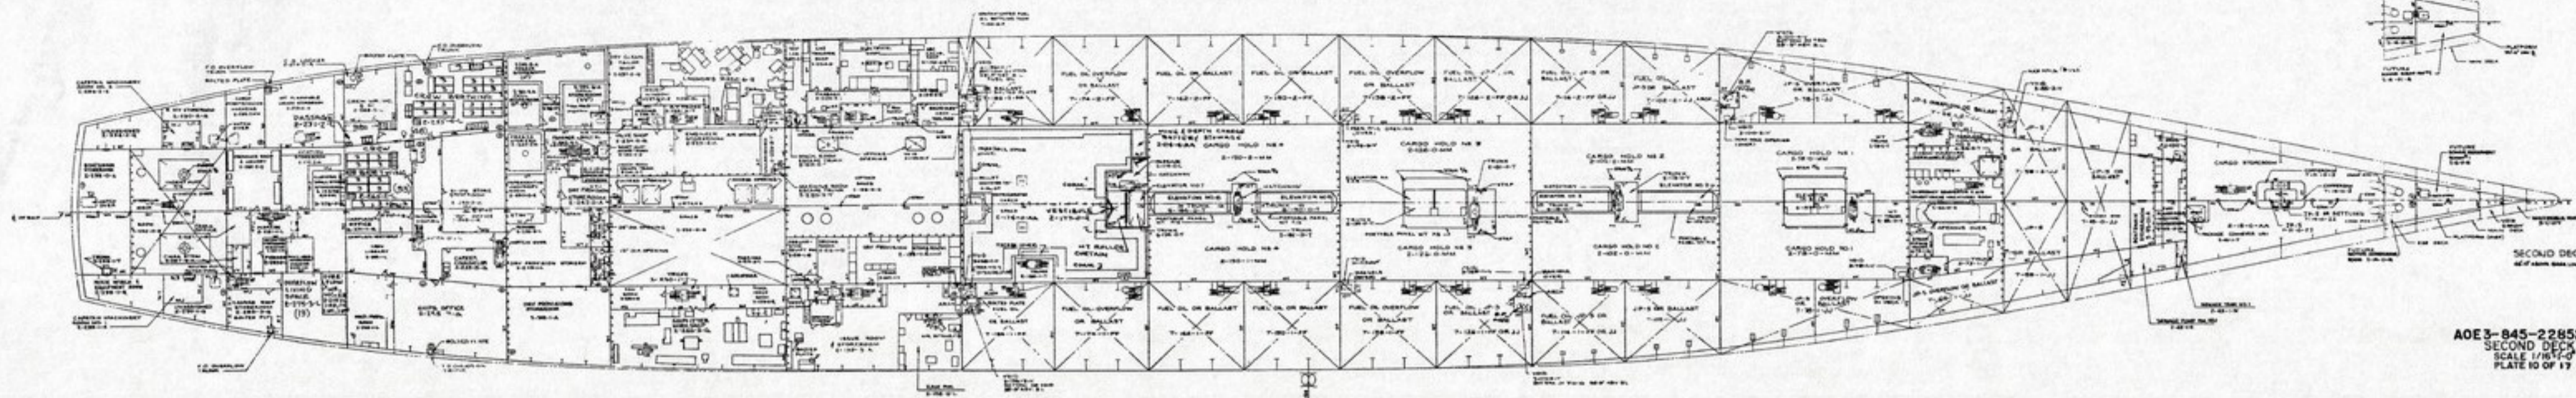


| REVISIONS | | DATE | BY | CHK'D | U.S.N. |
|-----------|------|--|--------------|-----------|-----------|
| ZONE | REV. | DESCRIPTION | | DATE/TIME | SIGNATURE |
| A | | THIS PLAN HAS BEEN CHECKED AGAINST ACTUAL CONDITIONS BY PHYSICAL SURVEY AND HAS BEEN UPDATED TO INCLUDE ALL MODIFICATIONS AND CHANGES DURING R.O.H. AT COASTAL PIER YACHT AND REPAIR CORP., 1980. | R.G. BLOOM | 3-17-88 | |
| B | | COMPARTMENT CHANGES MADE IN PLATES 10, 11 AND 2 DURING FY85 PMA NORSHIPCO. | R.G. BLOOM | | |
| C | | 1. ADDED VERTICAL LADDER, H2725 (P). 2. CHANGED BOATSWAIN STOREROOM 2-296-O-0 TO 2-296-O-4. | SJR 12/29/86 | | |


SEE SHEET 1 FOR REVISIONS

SHEET 4 OF 4

SELECTED RECORD DRAWING
TITLE BOOKET OF GENERAL DRAWINGS 5th DECK 1st PLTFORM 3rd PLTFORM
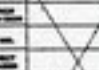
| | | | |
|--|---|---|---|
| PUGET SOUND NAVAL SHIPYARD | | | |
| BREMERTON, WASHINGTON | | | |
| EXAMINED | USS SEATTLE (AOE 3) | | |
| <div style="text-align: center;"></div> | BOOKLET OF GENERAL DRAWINGS | | |
| | 2nd DECK 1st PLATFORM 2nd PLATFORM | | |
| | 2nd BOOKLET OF GENERAL DRAWINGS | | |
| | <div style="border: 1px solid black; height: 20px; width: 100%;"></div> | | |
| | <div style="border: 1px solid black; height: 20px; width: 100%;"></div> | | |
| | <div style="border: 1px solid black; height: 20px; width: 100%;"></div> | | |
| APPROVED | | DATE | |
| <div style="border: 1px solid black; height: 20px; width: 100%;"></div> | | <div style="border: 1px solid black; height: 20px; width: 100%;"></div> | |
| SELECTED RECORD DRAWING | SIZE | ENGINE ORIENT | DISPOSING DRAWING NO. |
| | 80064 | 845 | 2285203 |
| | SCALE | 1" = 1'-0" | <div style="border: 1px solid black; height: 20px; width: 100%;"></div> |

4

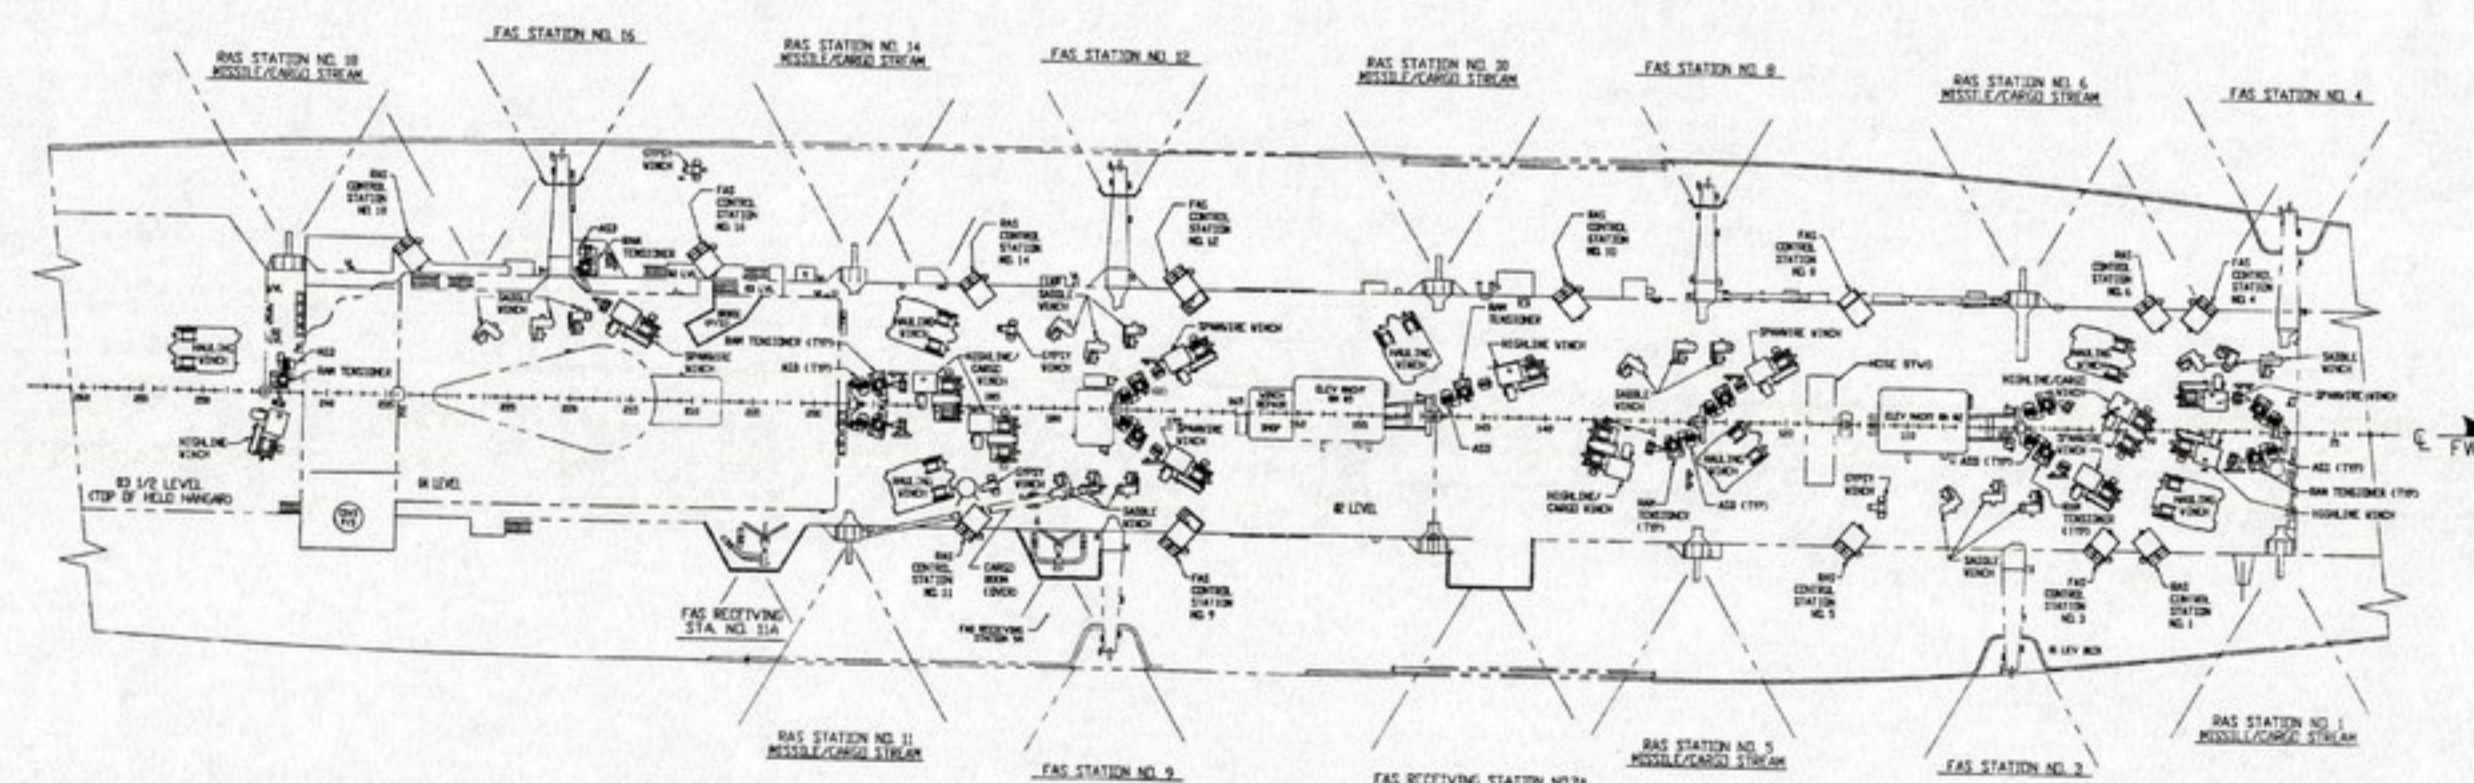

AOE3-845-2285203
PARTIAL PLAN 02, 03 1/2, & 04 LEVELS
UNREP EQUIPMENT ARRANGEMENT
SCALE: 1/16" = 1'-0"
PLATE 17 OF 17

PUGET SOUND NAVAL SHIPYARD
BREMERTON, WASHINGTON

USS SEATTLE (AOE3)
BOOKLET OF GENERAL DRAWINGS

AOE3-845-2285203

SCALE: 1/16" = 1'-0" SHEET 7 OF 7